


ZT\Data\GIS Data\MAPS\155\Makuu Well.mxd

Prepared by: Water Resource Associates Honolulu,

MAKUU EXPLORATORY WELL 3088-01
Halona, Puna, Hawaii

AS-BUILT SECTION

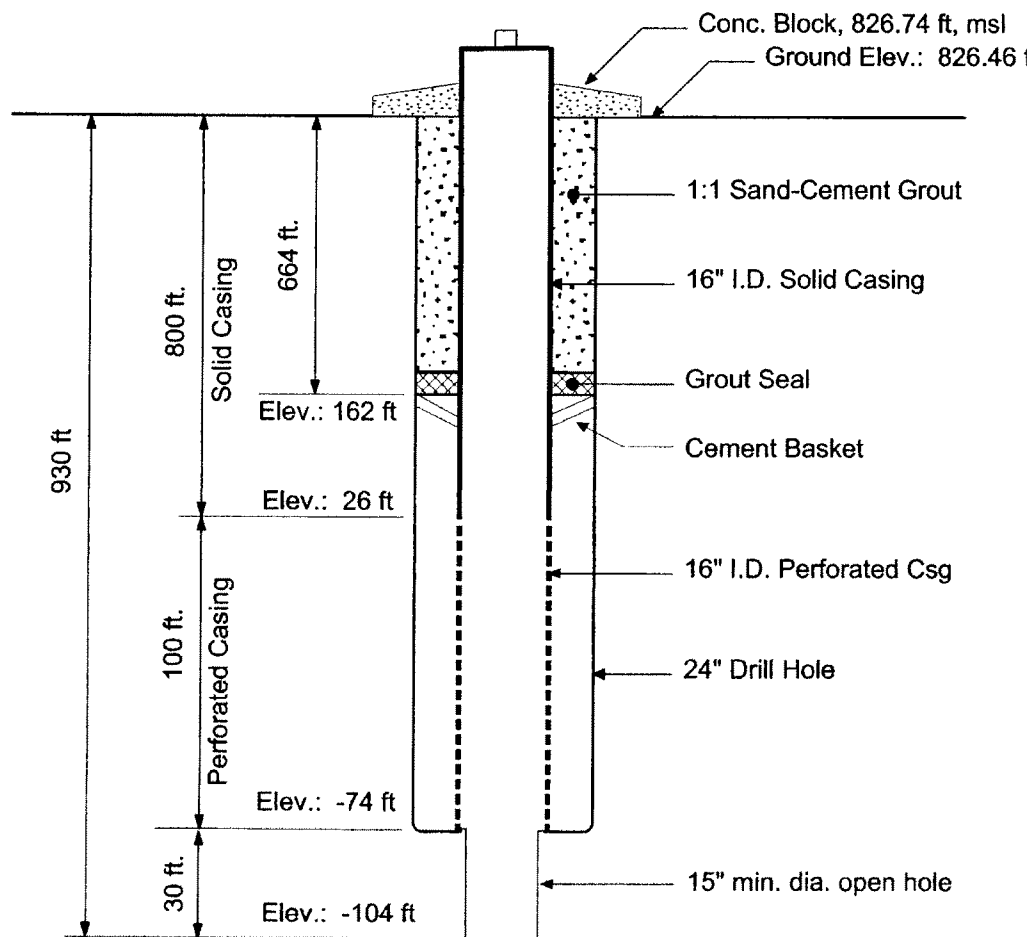

Not to Scale

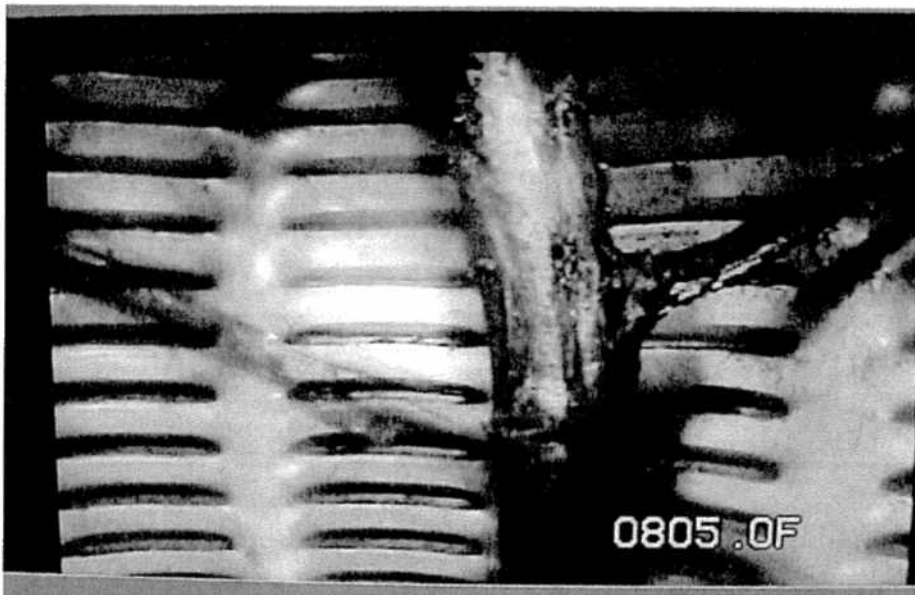


Photo 1. View of small stripped tree branch located 805.0 ft. below approximate ground level (Photo taken from video log of 12/7/11).

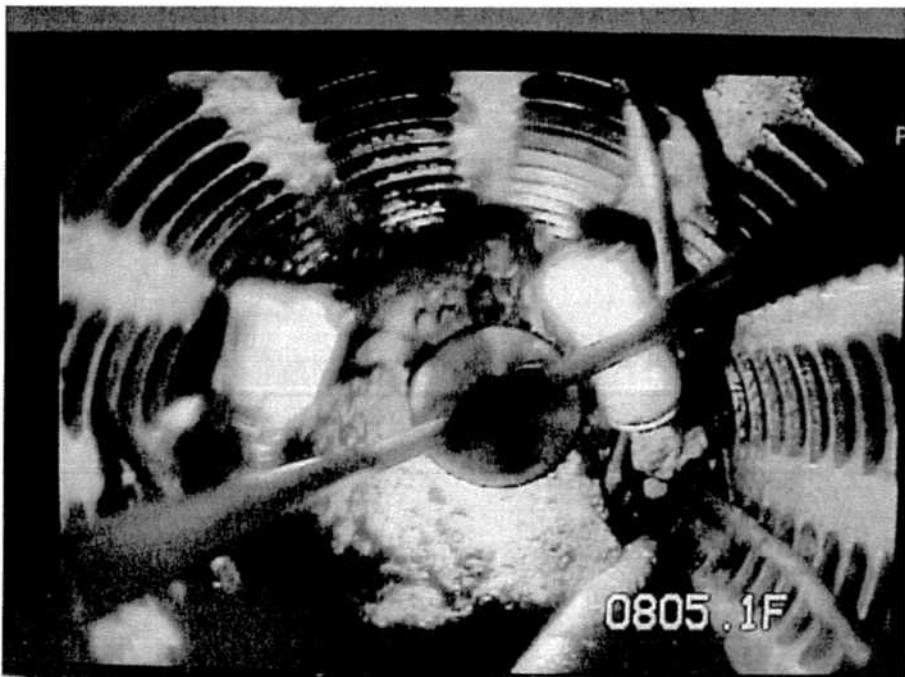


Photo 2. View of basalt rocks (gravel, cobble, and one 12" size), a can, plastic bottle, and stripped branches.